



City Yards Storage Building 16

Sample Number	Sample Description	Sample Location
A-001	Black Window Caulking	Room 101
A-002	Brown Building Caulking	Exterior
A-003	Black Firestop	Exterior
A-004	Black Window Caulking	Exterior

- GENERAL NOTES:
1. All dimensions are in millimetres.
 2. Drawings are not to be scaled.
 3. All drawings to be read in conjunction with the specifications, unless otherwise noted.
 4. Verify site conditions and location of all utilities prior to the start of construction.
 5. Report all discrepancies to the Consultant.
 6. If in doubt, ask.

NO.	DATE	REVISION DESCRIPTION
1	23/06	Created As-built for Field Check

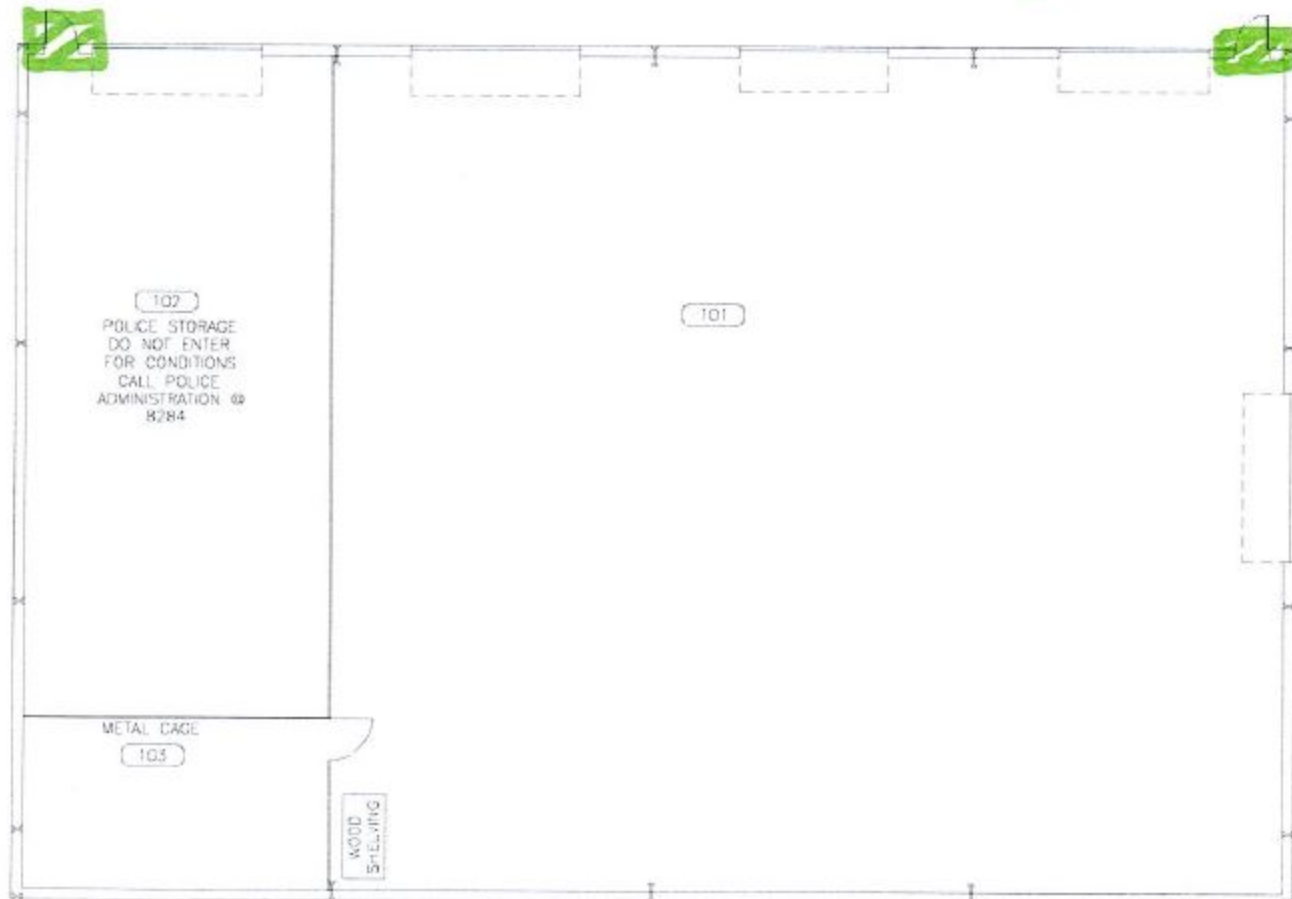

 Asbestos-Containing Window Caulking

Notes: 1) Asbestos is a carcinogen.
Avoid breathing dust.

ISSUED FOR	DATE
DESIGNED BY	DRAWN BY
CHECKED BY	DATE
	28/05/2006
PROJECT NAME	
Main Floor Furniture Plan	
PROJECT TITLE	
634.16 Yards Site V&E Storage	
PROJECT NO.	SHEET
REV. NO.	